
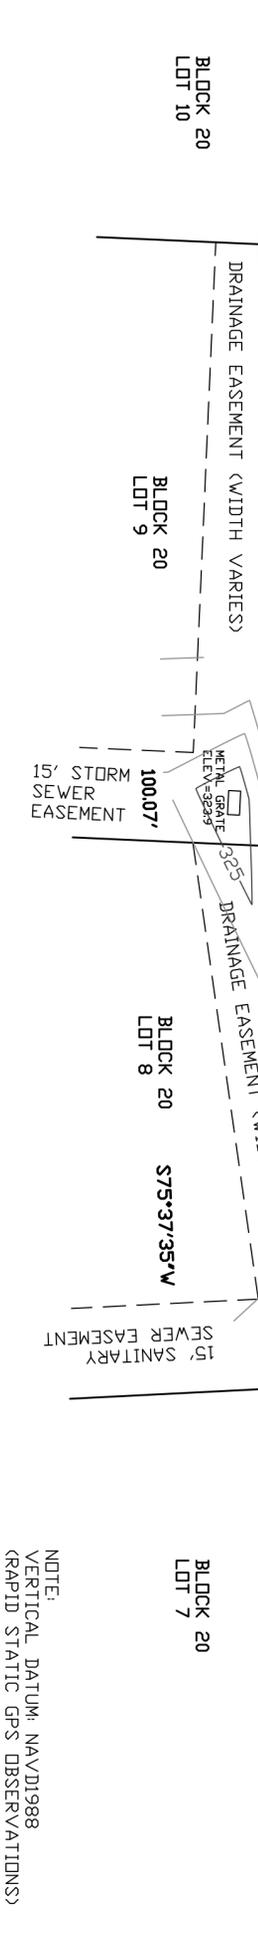


BUILDING HEIGHT AS PER AS-BUILT/EXISTING CONDITIONS.  
 AS-BUILDING AVERAGE GRADE ELEVATION = 401.5'  
 ( 389.0' + 414.0' ) / 2  
 AS-BUILT RIDGE HEIGHT ELEV. = 441.5'  
 AS-BUILT BUILDING HEIGHT = 40.0'  
 ( 441.5' - 401.5' )  
 AVERAGE GRADE = 40.0'  
 AS-BUILT BUILDING HEIGHT IS ABOVE THE 38.5' APPROVED VARIANCE HEIGHT.

NOTE:  
 AS-BUILT HIGH POINT GRADE ELEVATION HAS BEEN REVISED TO 414.0' AS PER PRE-DEVELOPMENT ORIGINAL TOPOGRAPHY.

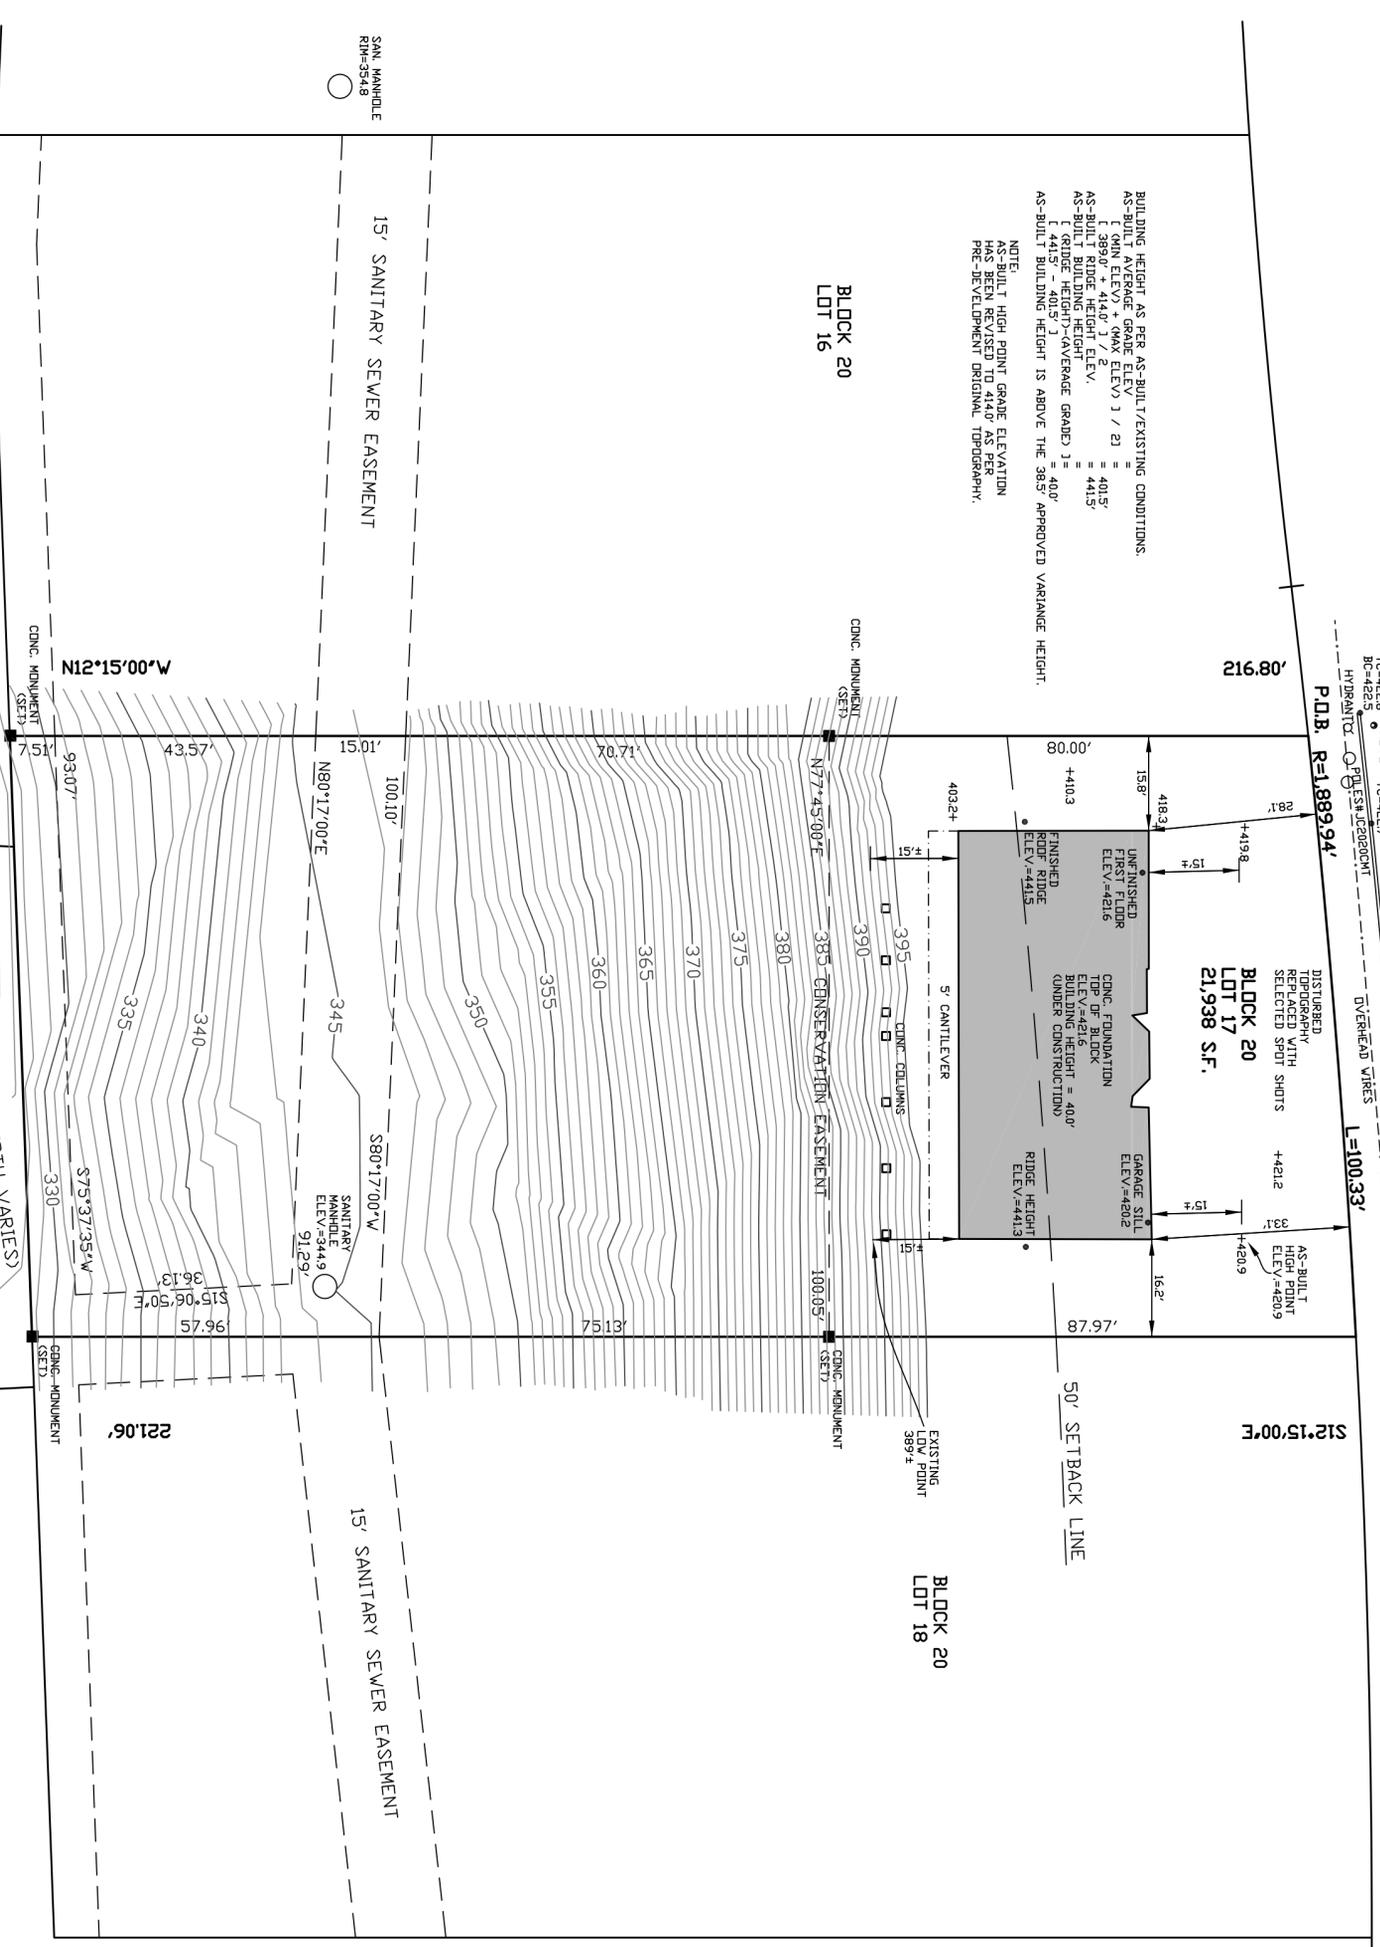

NOTE:  
 VERTICAL DATUM: NAVD1988  
 (RAPID STATIC GPS OBSERVATIONS)

Subject to any easements or restrictions that may affect the subject property. Boundary line determinations to be made by using the property corners as stated only. A written Waiver and directions Not to Set Corner Markers has been obtained from the ultimate user pursuant to N.J.A.C. 17:27. Subsequent to such data as an accurate search may reveal.

COPYRIGHT, 2019, DAB SURVEYING, INC.

DATE	REVISION
JAN. 02, 2020	REVISED GROUND ELEVATION FOR RIDGE HEIGHT CALCULATION TO PRE-DEVELOPMENT.
SEPT. 20, 2019	UPDATED AS-BUILT/EXISTING CONDITIONS IN ORDER TO CALCULATE BUILDING HEIGHT
JULY 17, 2019	ADDED RIDGE HEIGHT

**FOUNDATION LOCATION**

35 SUSAN DRIVE  
 BLOCK 20 ~ LOT 17  
 BOROUGH OF CHATHAM  
 MORRIS COUNTY, NEW JERSEY

SCALE: 1"=20'  
 973-838-4792 FAX 283-1659  
 SECTION 1 SITUATED IN THE TOWNSHIP OF CHATHAM MORRIS COUNTY, N.J., (2440) AND EVIDENCE IN THE FIELD.

**DAB**  
 SURVEYING INC.  
 170 KINNELDON ROAD  
 SUITE 25  
 KINNELDON, NJ 07405  
 CORPORATION REGISTRATION  
 51662795300

CERTIFIED TO: \_\_\_\_\_

SIGNED ON: JUNE 17, 2019  
 PROJECT NUMBER: 2018\_09\_0375  
 DUGLAS B. SMITH PROFESSIONAL LAND SURVEYOR N.J. LIC. 432324